



完成図 S=1:500

RevNo	Revision note	Date	Signature	Checked

管種	設計	実測	差引	図中色	凡例	記号
HIVPφ100	219.70	220.07	+0.37	青	仕切弁	⊗
					空気弁	Ⓐ

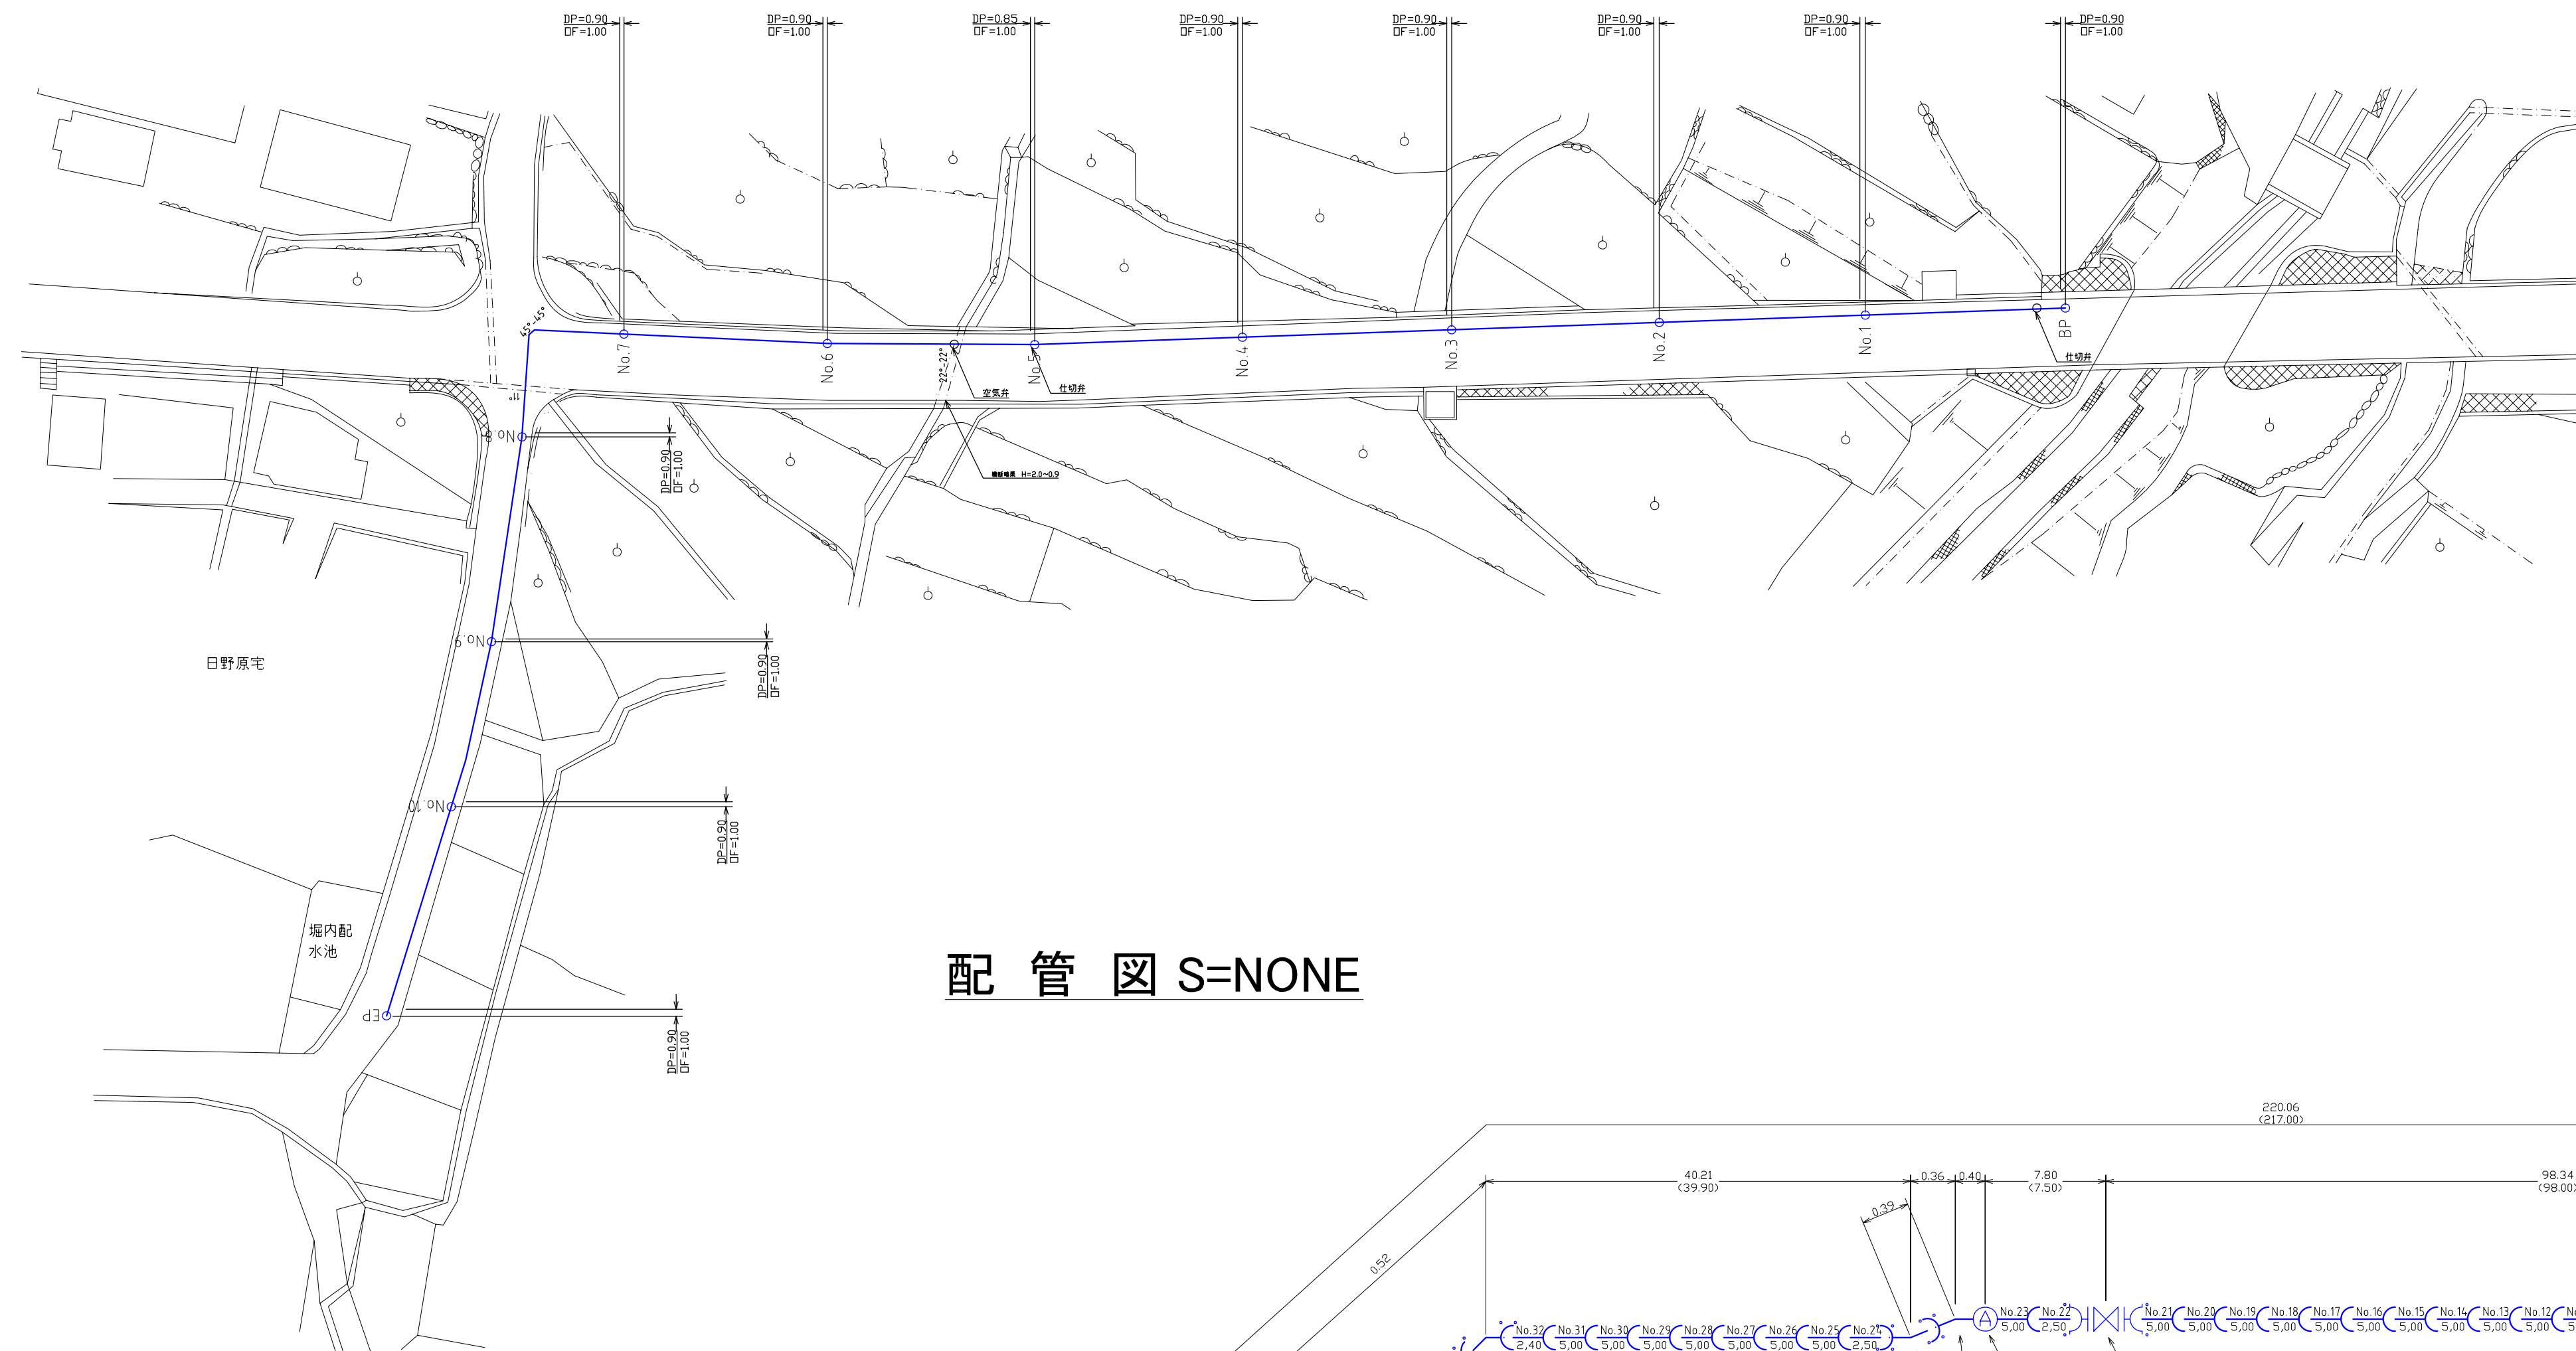

配管図 S=NONE

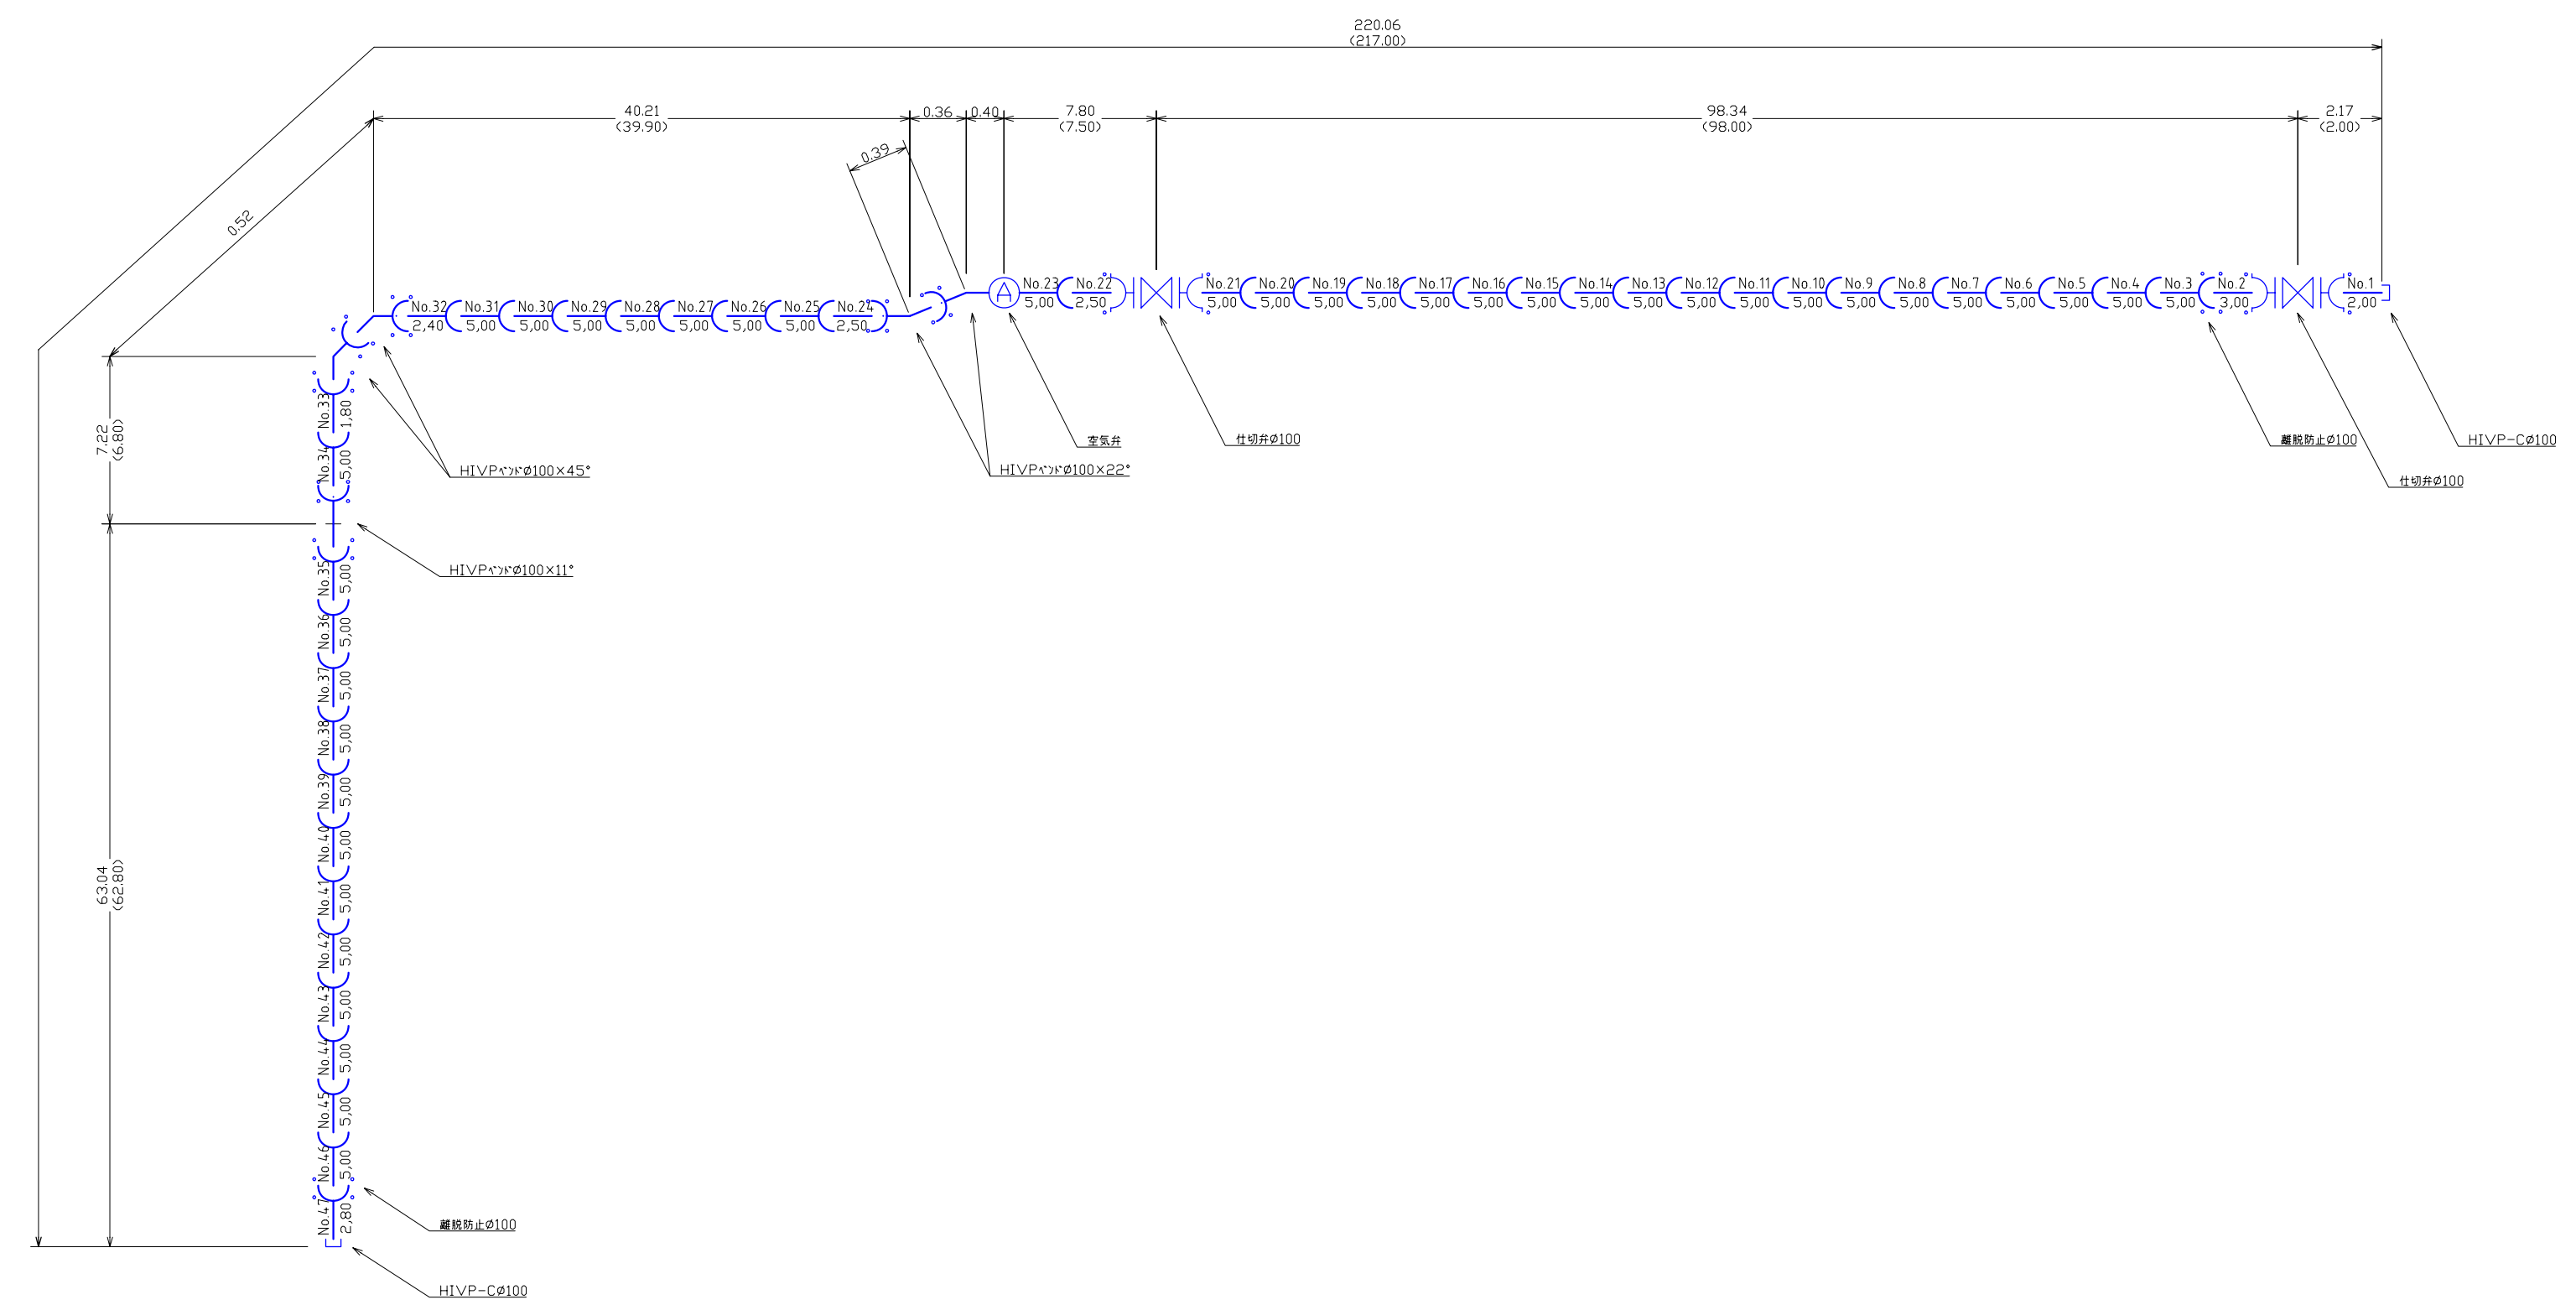

Itemref	Quantity	Title/Name, designation, material, dimension etc	Article No./Reference
Designed by Amemiya keiji	Checked by amemiya keiji amemiya keiji Corporation	Approved by - date 2004.06.25	Date 2004.09.
雨宮設備株式会社			完成図。配管図 DRAWING_NUMBER 16-48-1 Edition 3 Sheet 1/1